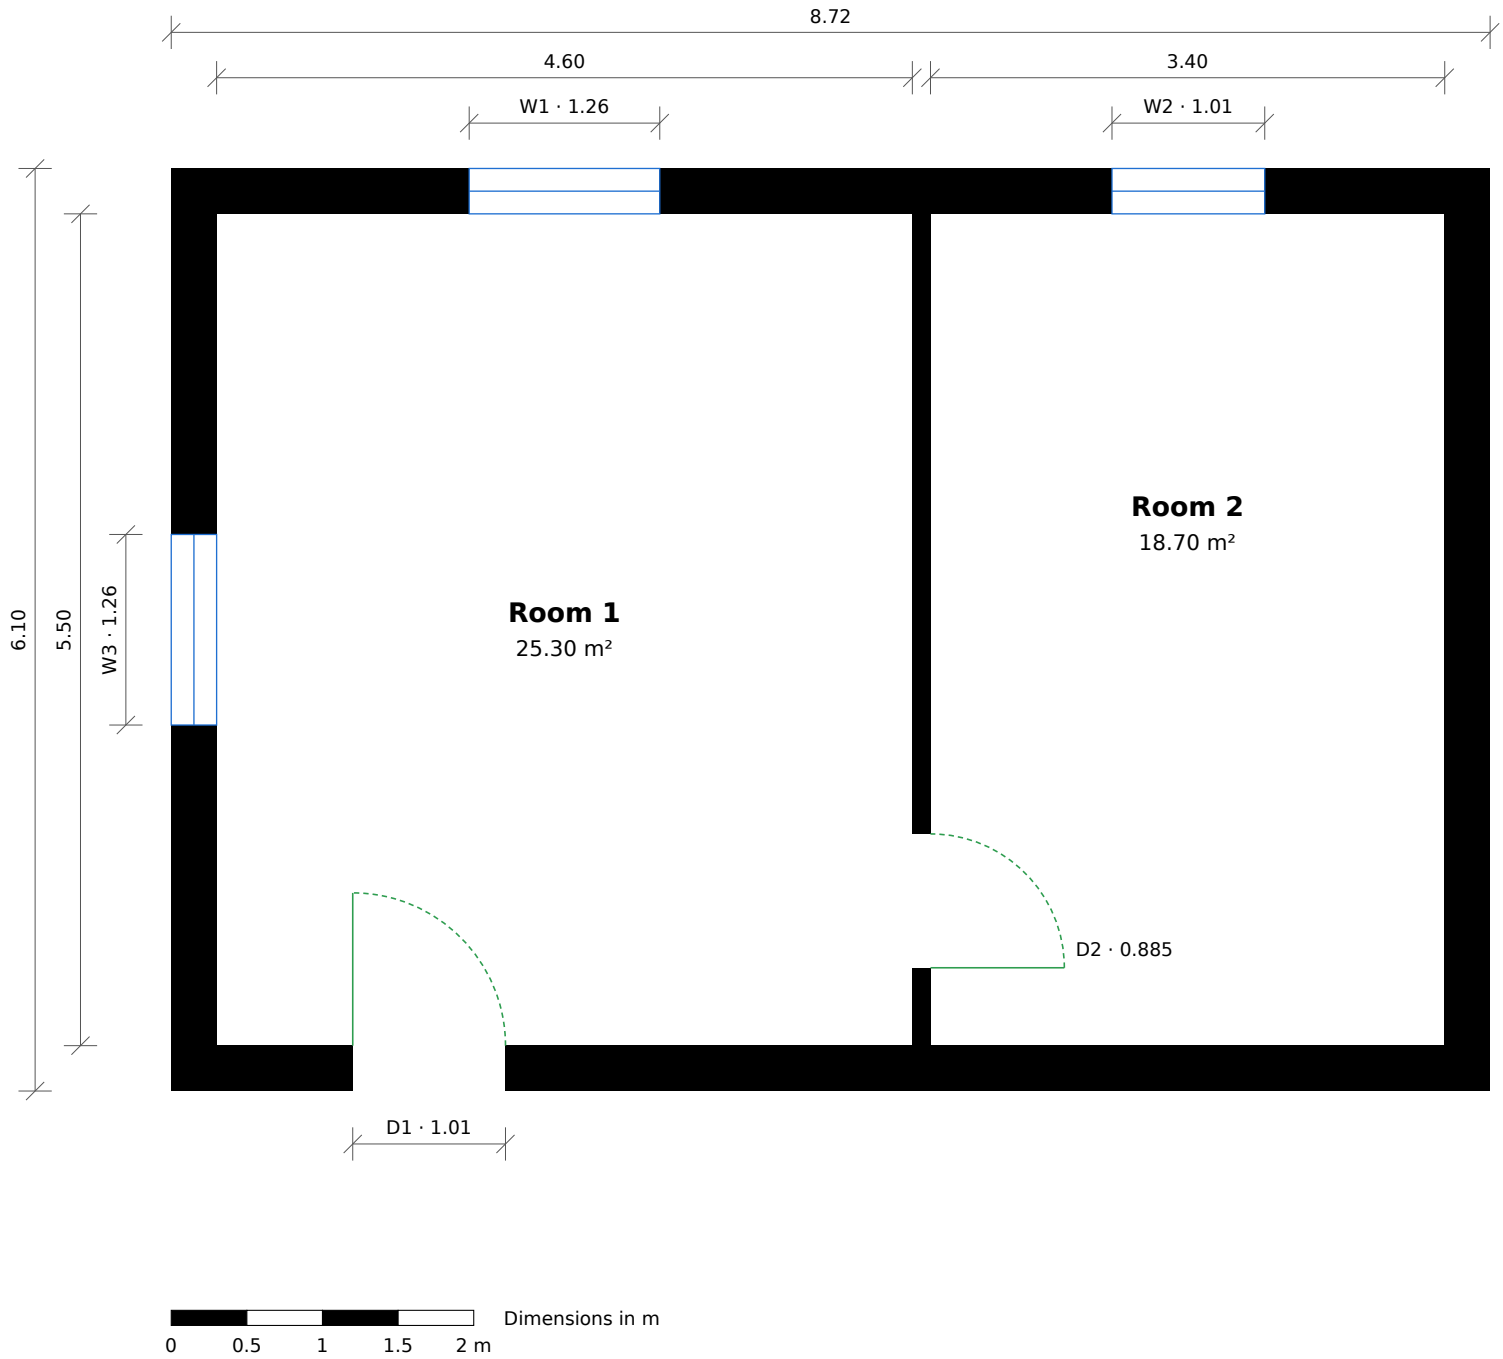

NPB Scan

As-built floor plan – sample

Ground-floor section with two rooms · Schematic sample data

Scale 1:50 (A4)
To scale only when printed at 100 % (no “fit to page”).

Revision
05.11.2026 / Rev. 01

Drawing no. NPB-SAMPLE-GF-01
Sheet 1/1

Net room areas
Room 1: 25.30 m² (4.60 × 5.50 m)
Room 2: 18.70 m² (3.40 × 5.50 m)

Overall dimensions: 8.72 × 6.10 m

W1, W2, W3 Window: 1.26 / 1.01 / 1.26 m
Sill 0.90 m · Head 2.10 m
D1, D2 Door: 1.01 / 0.885 m

Legend

- Wall (cut)
- Window with glass line
- Door with swing
- Dimension chain in m

- Scope: visible geometry (walls, openings, room areas).
- Schematic sample data created by NPB Scan for this website.
- Not an actual survey, not a client project.
- Not approved for construction; does not replace structural or specialist design.
- Accuracy, level of detail and formats are agreed per commission.

NPB Scan – a division of No Planet B Energy GmbH
Kammerstraße 36, 47057 Duisburg
+49 (0) 203 600 151 60 · contact@npb-scan.com